


## Chenango Canal Survey, New Hartford showing Palmer and Lusk

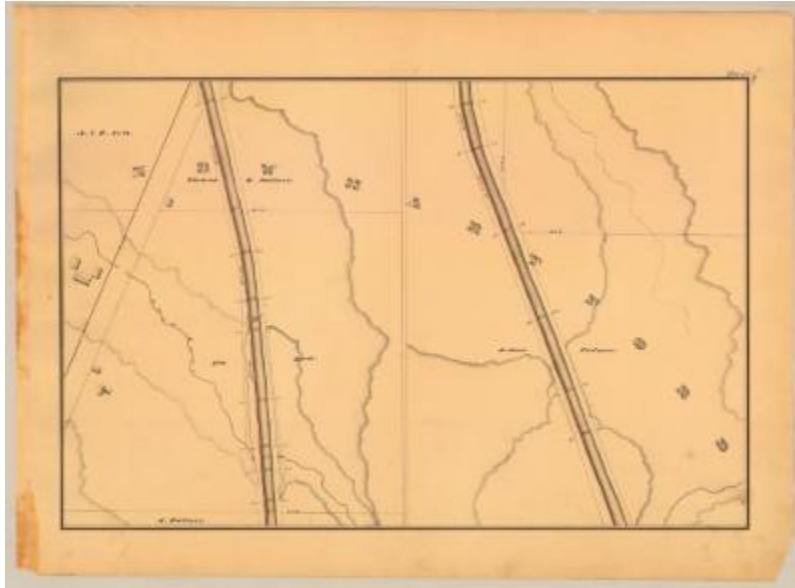

This is an ink, wash and charcoal map of a section of the Chenango Canal in New Hartford. The map is split into two views. The first view shows the Lusk Rill, a culvert, a bridge, six buildings and an unidentified road. The second view shows only the canal. The red lines indicate courses and distances. The blue lines indicate canal right-of-way. The map also shows the properties of A. and E. Ives, Thomas R. Palmer, Joshua Palmer and Ira Lusk.

### Identifier

NYSA\_A0848-77\_MC7\_DR15\_V16\_CHEN1\_9

### Alternate Identifier

DMS ID Number: 151056

### Date

1838

### Repository

New York State Archives

### Source

New York State Archives, A0848-77, Canal System Survey Maps, 1832-1843, Map no. CHEN1-9

### Rights

This image is provided for education and research purposes. Rights may be reserved. Responsibility for securing permissions to distribute, publish, reproduce or other use rest with the user. For additional information see our [Copyright and Use Statement](#)

### More From This Series

Canal Commissioners canal system survey maps

### Geographic Locations

Oneida County (is associated with)