


Chenango Canal Survey, Chenango showing two views of the Canal, Lock No. 106 and Chenango River

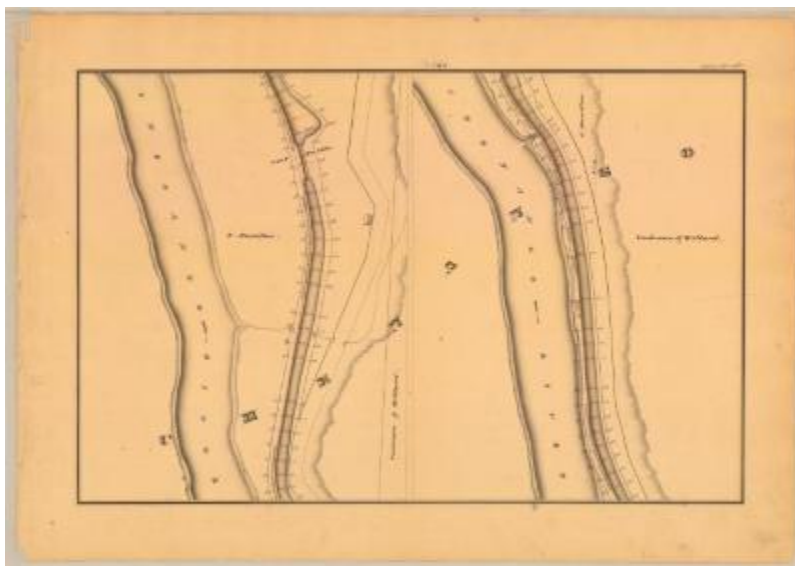

This is an ink, wash and charcoal map of a section of the Chenango Canal in Chenango. The map is split into two views. The first view shows the Chenango River, a stream that runs under the canal through a culvert and into the river, a large basin, Lock No. 106, a building and an unidentified road. The second view shows the Chenango River and a point where the river connects to the canal. The red lines indicate courses and distances. The blue lines indicate canal right-of-way. The map also shows the properties of G. Hamilton, Cushman and Willard.

Identifier

NYSA_A0848-77_MC8_DR1_V17_CHEN2_140

Alternate Identifier

DMS ID Number: 151293

Date

1838

Repository

New York State Archives

Source

New York State Archives, A0848-77, Canal System Survey Maps, 1832-1843, Map no. CHEN2-140

Rights

This image is provided for education and research purposes. Rights may be reserved. Responsibility for securing permissions to distribute, publish, reproduce or other use rest with the user. For additional information see our [Copyright and Use Statement](#)

More From This Series

Canal Commissioners canal system survey maps

Geographic Locations

Broome County (is associated with)